

REVIEW BY FORT BEND COUNTY COMMISSIONERS COURT

On this 14th day of June, 2016, Commissioners Court came on to be heard and reviewed the accompanying notice of Harris Construction Company, LTD.

Job Location GRAND PARKWAY & SOMERLED AVENUE, RICHMOND, TX 77407

Date 6/3/2016 Bond No. SW9708, Permit No. 2016-7502 to make use of certain Fort Bend County property subject to, "A Revised Order Regulating the Laying, Construction, Maintenance, and Repair of Buried Cables, Conduits, and Pole Lines, In, Under, Across or Along Roads, Streets, Highways, and Drainage Ditches in Fort Bend County, Texas, Under the Jurisdiction of the Commissioners Court of Fort Bend County, Texas," as passed by the Commissioners Court of Fort Bend County, Texas the 3rd day of August, 1987, recorded in Volume _____ of the Minutes of the Commissioners Court of Fort Bend County, Texas, to the extent that such order is not inconsistent with Article 1436a, Vernon's Texas Civil Statutes. Upon Motion of Commissioner _____, seconded by Commissioner _____, duly put and carried, it is ORDERED, ADJUDGED AND

DECREED that said notice of said above purpose is hereby acknowledged by the Commissioners Court of Fort Bend County, Texas, and that said notice be placed on record according to the regulation order thereof.

Notes:

1. Evidence of review by the Commissioners Court must be kept on the job site and failure to do so constitutes grounds for job shutdown.
2. Written notices are required:
 - a. 48 hours in advance of construction start up, and
 - b. when construction is completed and ready for final inspection
 Mail notices to: Permit Administrator
 Fort Bend County Engineering
 301 Jackson Street
 Richmond, Texas 77469
 281-633-7500
3. This permit expires one (1) year from date of permit if construction has not commenced.

By: *Charles O. DeJ*
for County Engineer



Presented to Commissioners Court and approved.
Recorded in Volume _____
Minutes of Commissioners Court

By: N/A
Drainage District Engineer/Manager

Clerk of Commissioners Court

By: _____
Deputy

APP-8103

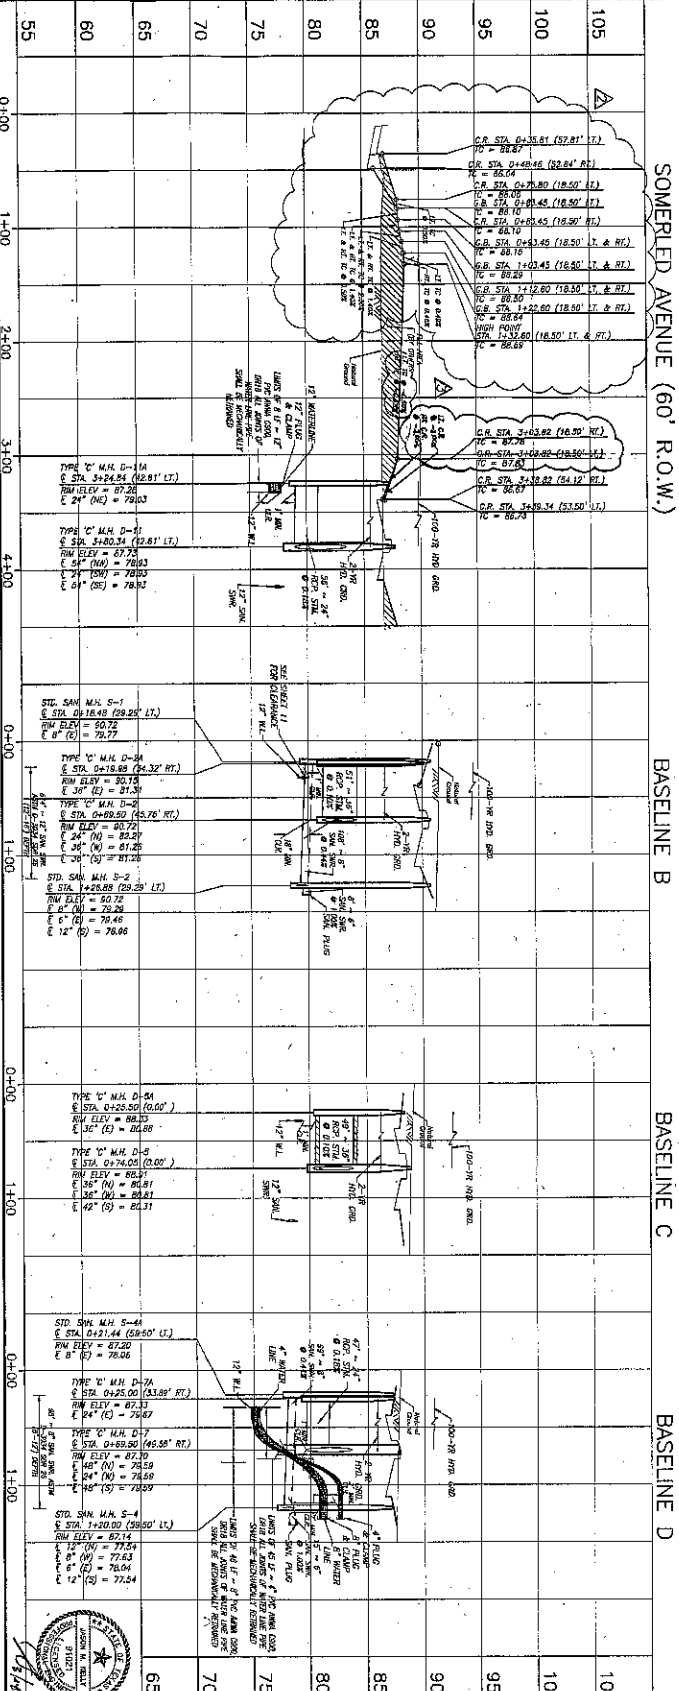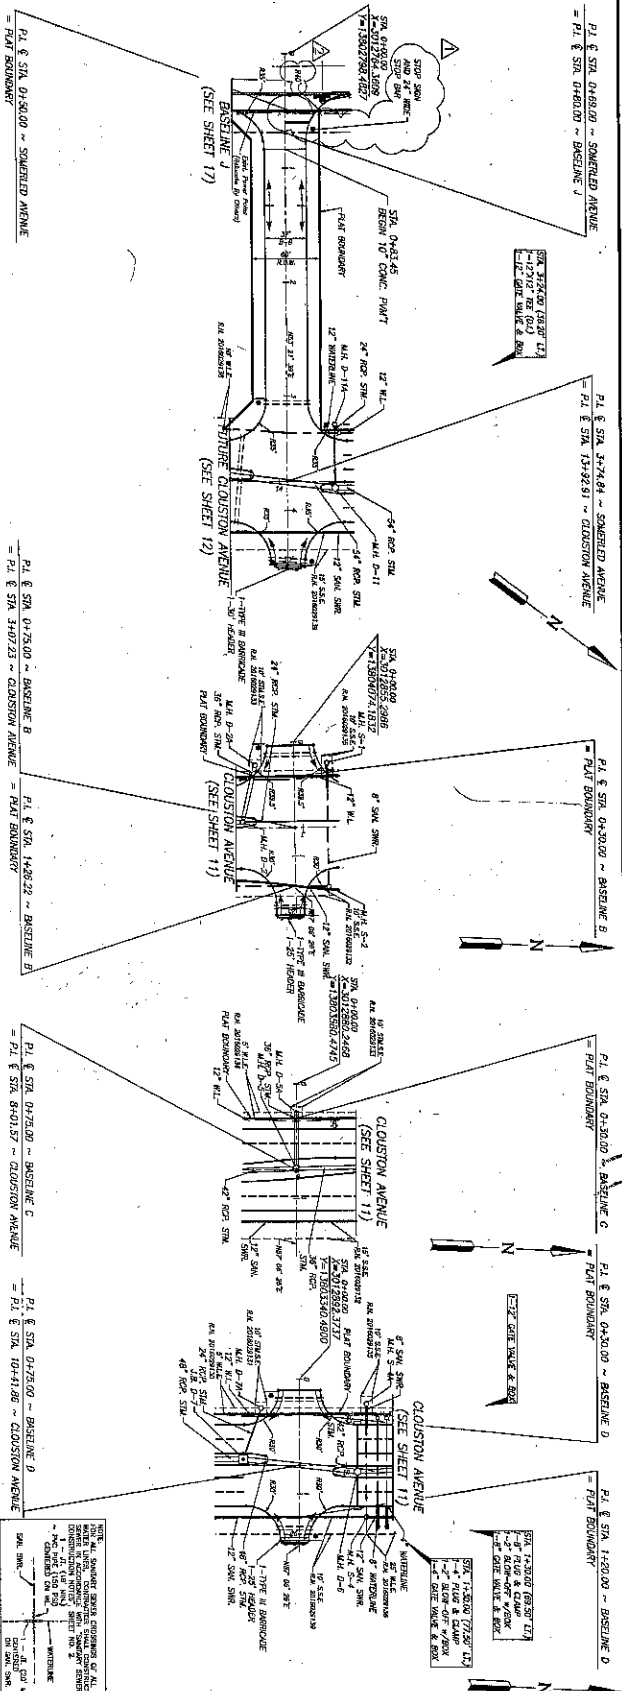

RECORD DRAWING
 APPROVED BY: [Signature]
 DATE: 4/27/14
 ENGINEER: [Signature]
 DATE: []

PLAT NAME: SOMERLED AVENUE IN CLOUSTON AVENUE STREET DEVELOPMENT
 CFC 101 FILE NO. 2013-0087
 CDD L102 NO. 16-0108
 ALMA DEVELOPMENT COMPANY
 CLOUSTON AVENUE AND SOMERLED AVENUE



DATE: 4/27/14

City of Houston
 Department of Public Works
 Engineering Division
 City Engineer: [Signature]
 Date: []

City of Houston
 Department of Public Works
 Engineering Division
 City Engineer: [Signature]
 Date: []

City of Houston
 Department of Public Works
 Engineering Division
 City Engineer: [Signature]
 Date: []

DATE: 11/23/2016 10:43:00 AM USER: JH/STP/STP
PROJECT: 17883-1042-0001 PLAN: 17883-1042-0001

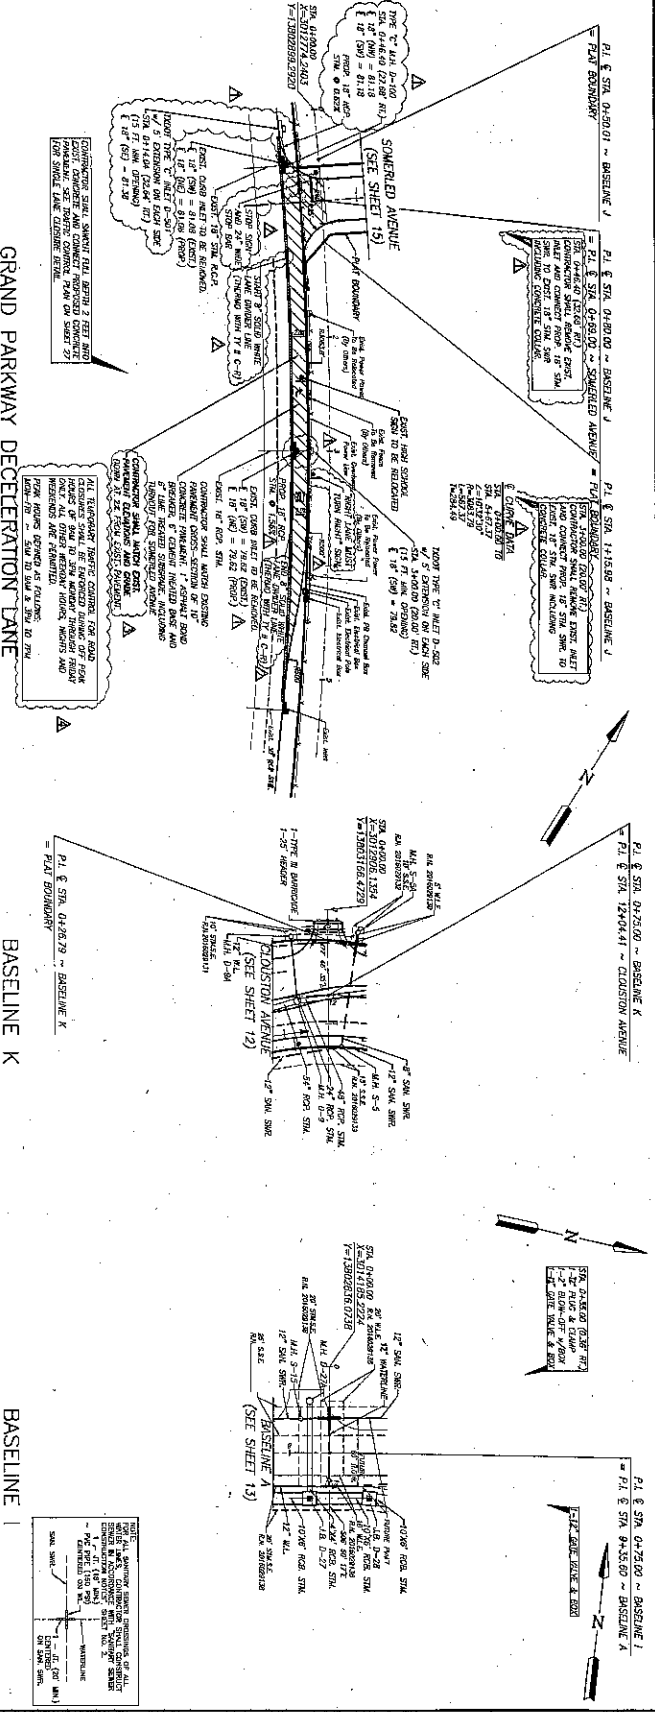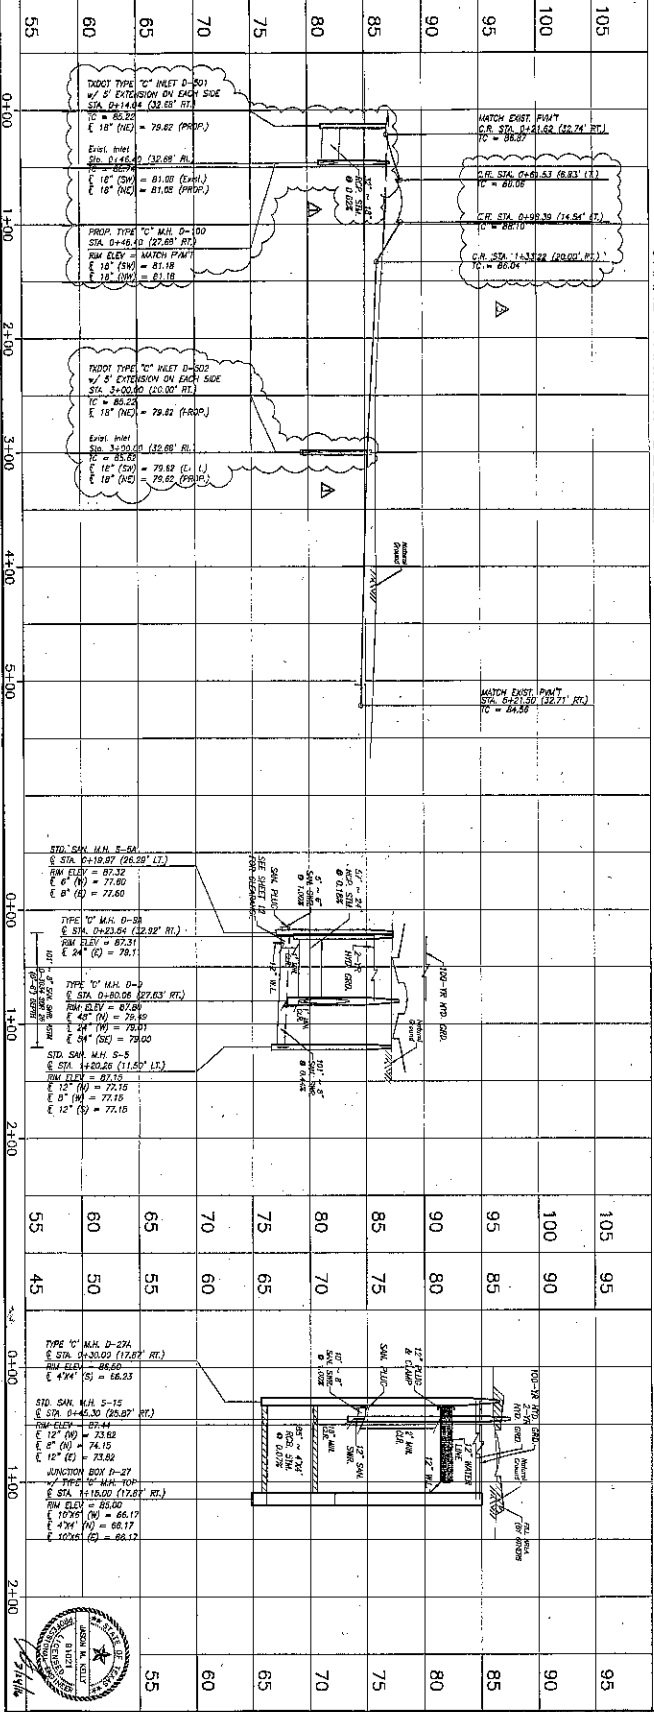

CITY OF HOUSTON

PLANNING DEPARTMENT

DATE: 11/23/2016 10:43:00 AM

PROJECT: 17883-1042-0001

PLAN: 17883-1042-0001

DATE: 11/23/2016 10:43:00 AM

PROJECT: 17883-1042-0001

PLAN: 17883-1042-0001

DATE: 11/23/2016 10:43:00 AM

PROJECT: 17883-1042-0001

PLAN: 17883-1042-0001

RECORD DRAWING

FOR THE CITY OF HOUSTON

DATE: 11/23/2016 10:43:00 AM

PROJECT: 17883-1042-0001

PLAN: 17883-1042-0001

DATE: 11/23/2016 10:43:00 AM

PROJECT: 17883-1042-0001

PLAN: 17883-1042-0001