

Modification/Change Order No.6

Bid Number: 21-020

PO #: 195195

Fort Bend County Drainage District

EWP – Oyster Creek Channel Bank Stabilization Phase II

Fort Bend County, Texas

October 21, 2021

CHANGE ORDER/MODIFICATION NO. 6		Effective Date:	Page 1 of 2
Contract: 21-020	Dated: 12/16/2019	Project: EWP – Oyster Creek Channel Bank Stabilization Phase II	
Issued By (Contracting Local Organization): Fort Bend County		Issued To (Contractor): NBG Constructors, Inc	
TYPE OF MODIFICATION (<i>check appropriate box below</i>)			
☒ CHANGE ORDER: Issued pursuant to Article 14.4 the changes set forth below are made by this modification.			
Contract Price	\$5,293,457.97	PERFORMANCE TIME:	
Net Increase in Contract Price:	\$ 47,500.00		
REVISED Contract Price:	\$5,340,957.97		
ATTACHMENTS (<i>If none, so state.</i>):			
This modification is hereby made a part of the contract. Except as provided herein, all terms and conditions of the original contract (as revised) remain unchanged and in full force and effect.			
CONTRACTOR'S RELEASE OF CLAIMS In consideration of the modification agreed to herein as complete equitable adjustment for the Contractors proposal, dated 10-2-2021, the Contractor hereby releases Fort Bend County from any and all liability under this contract for further equitable adjustments attributable to such facts or circumstances concerning the added work for the above added work, including all impacts to the work, overhead and profit.			
Recommended By: (print or type name/title of signer) Thomas P. Beach, PE M&E Consultants <i>Thomas P Beach</i>			
Important Note: Contractor IS required to sign this document and return two (2) copies to the issuing office.			
CONTRACTOR (print or type name/title of signer) Robert T. Rogers III Vice President		Sponsors/Contracting Local Organization Adam Wright Fort Bend County Drainage District	
SIGNATURE (person authorized to sign) Robert T. Rogers III Digitally signed by Robert T. Rogers III DN: c=US, o="NBG Constructors, Inc.", cn=Robert T. Rogers III, E=rbt@nbgconstructors.com Reason: I am approving this document Location: Houston, TX Date: 2021-10-22 13:17:54 Foxit PhantomPDF Version: 9.7.1	DATE 10/22/20	SIGNATURE (County Judge)	DATE

Modification/Change Order No.6
Fort Bend County Drainage District
EWP – Oyster Creek Phase II Channel Bank Stabilization
Fort Bend County, Texas
October 21, 2021
Contract No: PO 195195

DESCRIPTION OF MODIFICATION/CHANGE ORDER

Pursuant to General Condition, Article 14.4, the contract shall be modified as following.

Contractor shall furnish all material, equipment and labor to place relocate the steel sheet pile wall on Site 428 (P4 to P5) as shown on the attached drawing. Materials shall be salvaged and reused to complete the required wall. Compensation for this change is lump sum as shown below.

Changes to the Bid Schedule:

Item No.	Work or Material	Spec.	Quantity	Units	Unit Price	Amount
27	Site 428 Wall Relocate	13	1	LS	\$xxxx	\$ 47,500.00

Contract price increase – \$47,500.00
Contract Performance time: - none

CONTRACTOR’S STATEMENT OF RELEASE

In consideration of the modification agreed to herein as complete equitable adjustment for the Contractors proposal, dated 10-21-2021, the Contractor hereby releases Fort Bend County from any and all liability under this contract for further equitable adjustments attributable to such facts or circumstances concerning the added work for the above added work, including all impacts to the work, overhead and profit.



9702 Synott Road
Houston, TX 77083
281-495-0842

October 21, 2021

M & E Consultants, LLC
ATTN: Tom Beach, P.E., Construction Engineer
Fort Bend County Drainage District
EWP Oyster Creek Bank Stabilization, Phase 2
Fort Bend County, Texas

RE: Modification Pricing Request – Realignment of Site 428

Mr. Beach,

NBG Constructors, Inc. respectfully submits lump sum pricing of \$47,500 to completely remove and replace approximately one-hundred, fifty-eight (158) feet of completed sheet pile wall to facilitate the revised alignment. The pricing is predicated on being able to reuse all existing materials, except for both the coarse and fine drain fill.

If you have any questions or require additional information I can be reached at (713) 419-6642.


Respectfully,

A handwritten signature in black ink, appearing to read "Bob Rogers", with a stylized flourish at the end.

Bob Rogers
Vice President

cc: 20-30 Project File

Y:\PUBLIC\Projects - Current\Fort Bend Oyster Creek, Phase 1 And I\DWG\OC Phase 2-MOD4.dwg

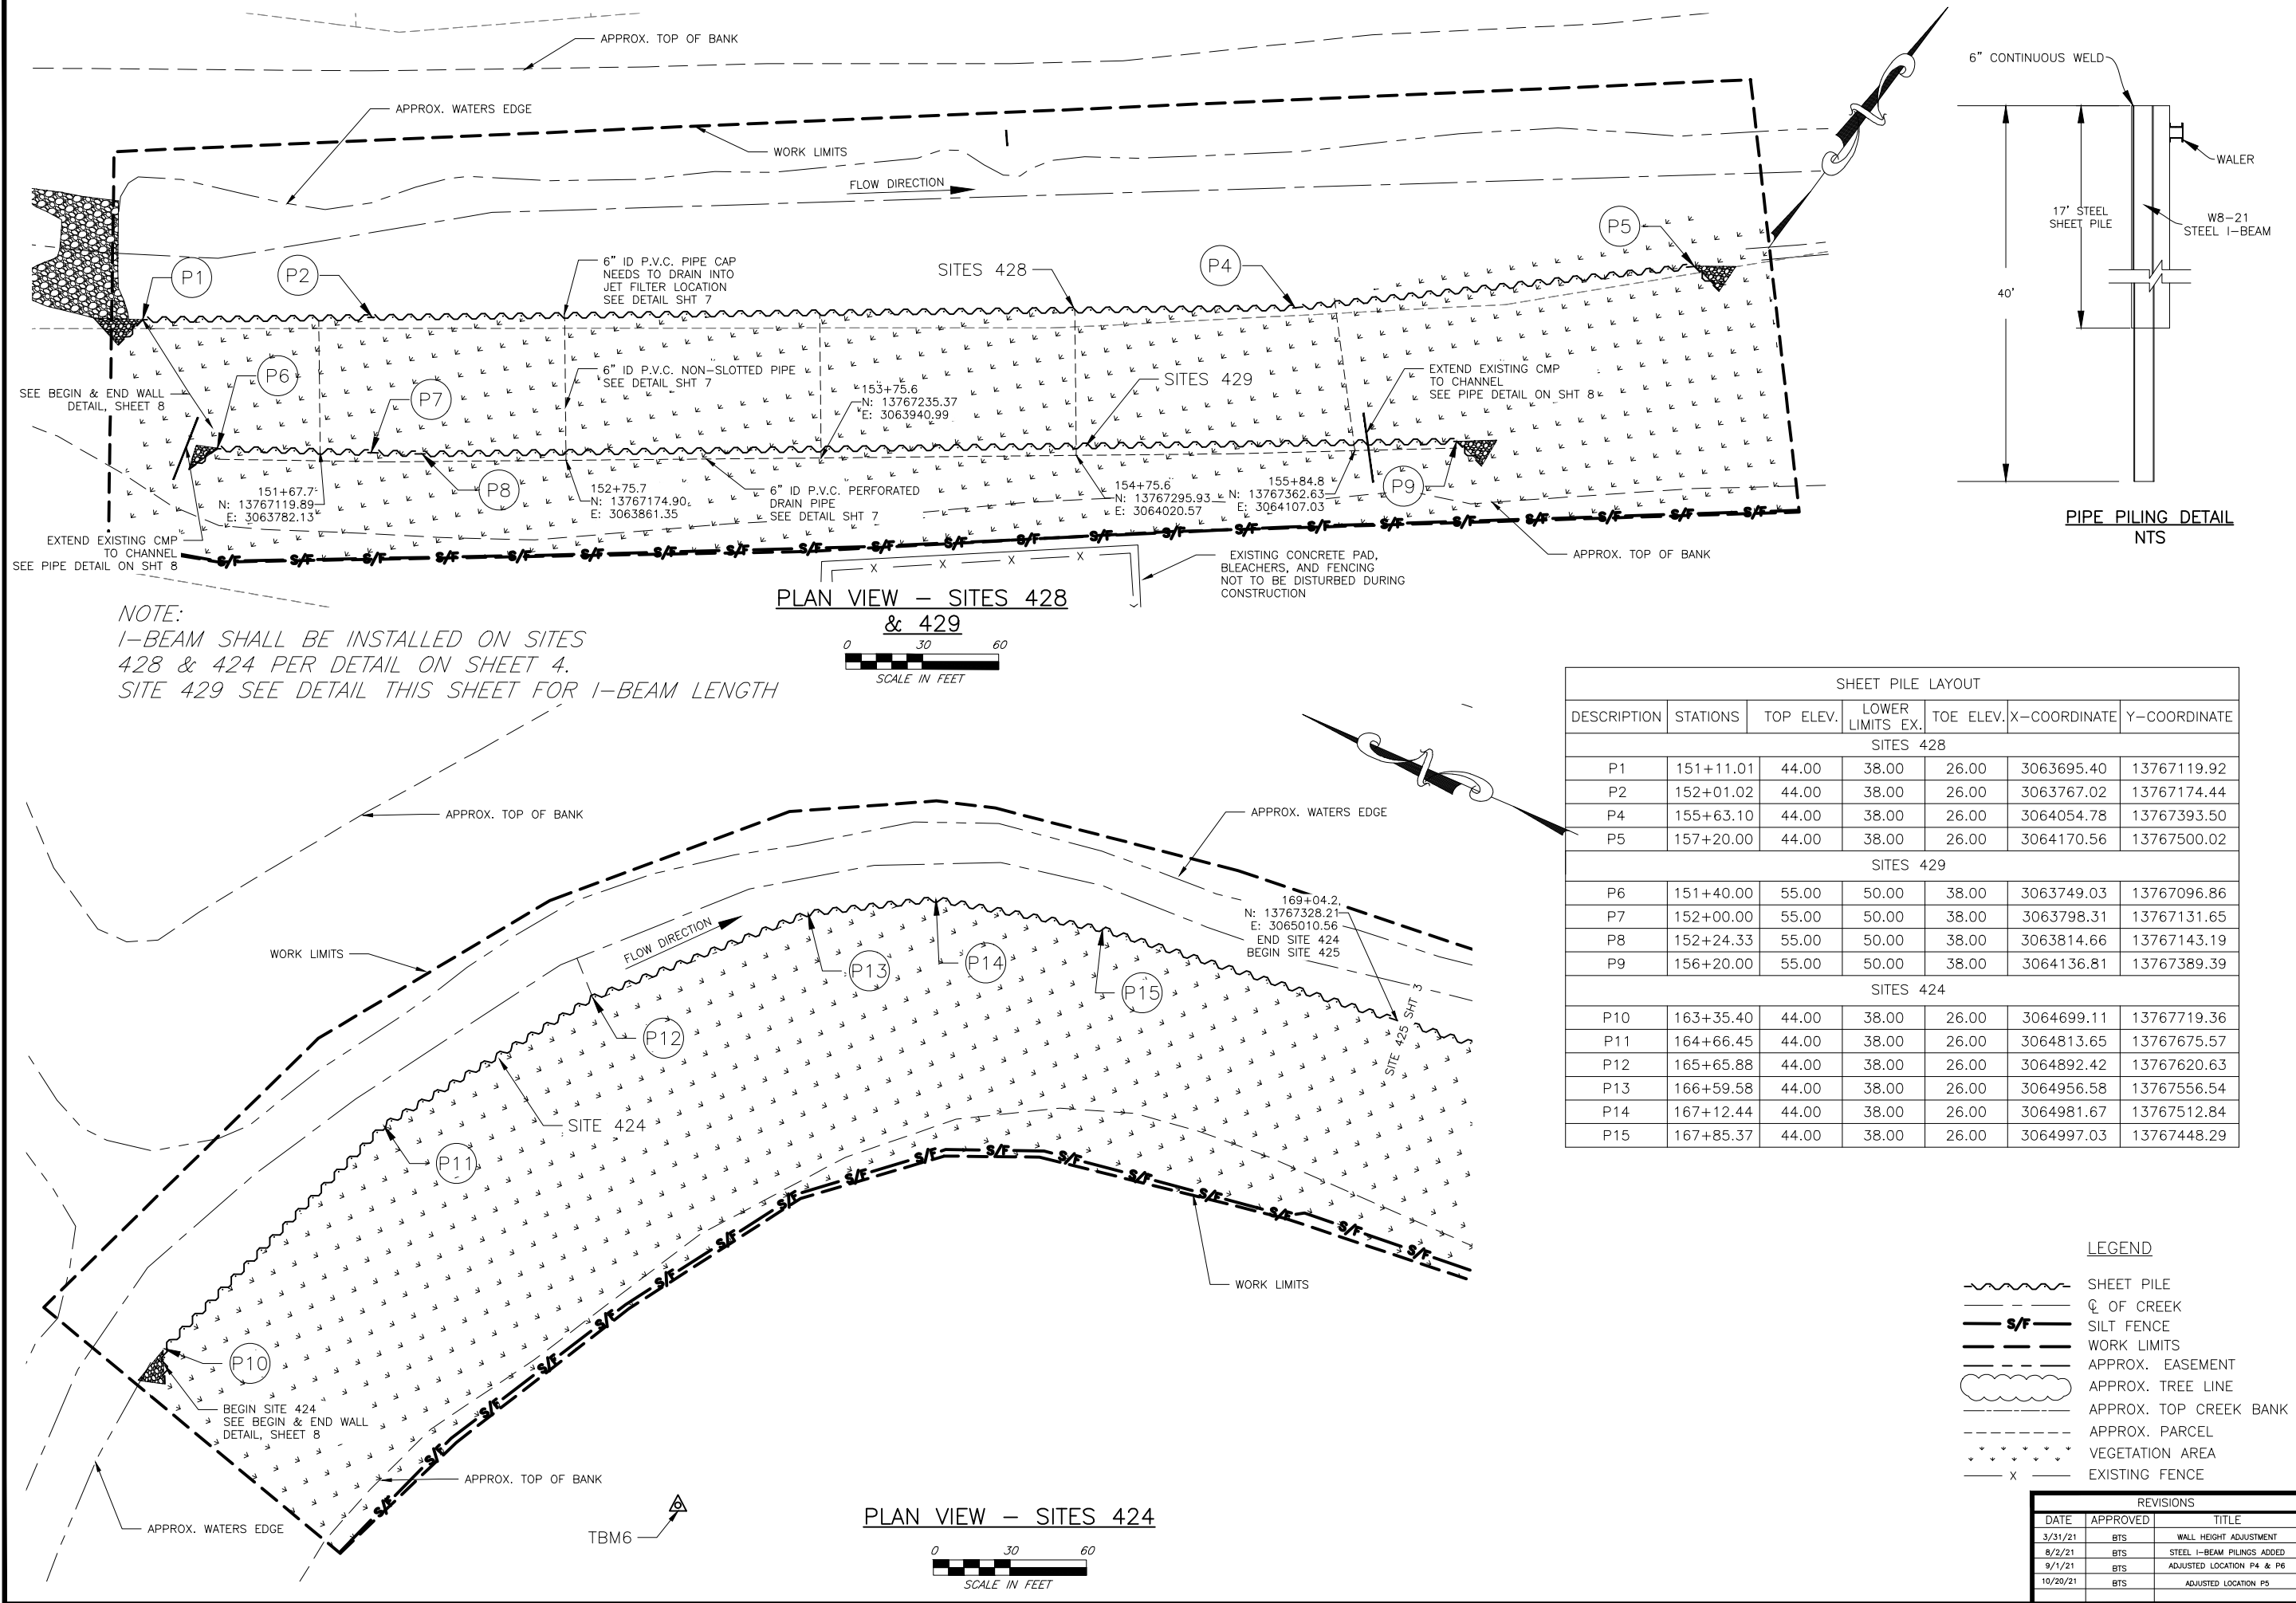

NOTE:
I-BEAM SHALL BE INSTALLED ON SITES
428 & 424 PER DETAIL ON SHEET 4.
SITE 429 SEE DETAIL THIS SHEET FOR I-BEAM LENGTH

SHEET PILE LAYOUT						
DESCRIPTION	STATIONS	TOP ELEV.	LOWER LIMITS EX.	TOE ELEV.	X-COORDINATE	Y-COORDINATE
SITES 428						
P1	151+11.01	44.00	38.00	26.00	3063695.40	13767119.92
P2	152+01.02	44.00	38.00	26.00	3063767.02	13767174.44
P4	155+63.10	44.00	38.00	26.00	3064054.78	13767393.50
P5	157+20.00	44.00	38.00	26.00	3064170.56	13767500.02
SITES 429						
P6	151+40.00	55.00	50.00	38.00	3063749.03	13767096.86
P7	152+00.00	55.00	50.00	38.00	3063798.31	13767131.65
P8	152+24.33	55.00	50.00	38.00	3063814.66	13767143.19
P9	156+20.00	55.00	50.00	38.00	3064136.81	13767389.39
SITES 424						
P10	163+35.40	44.00	38.00	26.00	3064699.11	13767719.36
P11	164+66.45	44.00	38.00	26.00	3064813.65	13767675.57
P12	165+65.88	44.00	38.00	26.00	3064892.42	13767620.63
P13	166+59.58	44.00	38.00	26.00	3064956.58	13767556.54
P14	167+12.44	44.00	38.00	26.00	3064981.67	13767512.84
P15	167+85.37	44.00	38.00	26.00	3064997.03	13767448.29

This document is released for the purpose of interim review and mark-up under the authority of B. Trent Street, P.E. 61421 on October 20, 2021. It is not to be used for construction, CONSULTANT'S bidding, permit, or contracting purposes.

DESIGNED BY: BTS
DRAWN BY: JPK
CHECKED BY: TPB
FILE NAME: OC Phase 2-MOD4.dwg
DATE CHECKED: 9/4/2020

SITE PLANS - 428, 429, & 424

OYSTER CREEK - BANK STABILIZATION

FORT BEND DRAINAGE DISTRICT

IN

FORT BEND COUNTY, TEXAS

USDA United States Department of Agriculture

Natural Resources Conservation Service

DRAWING NO. **TX-EN-0791**

SHEET NO. **2**

OF **11**