

### REVIEW BY FORT BEND COUNTY COMMISSIONERS COURT

On this 7th day of June, 2016, Commissioners Court came on to be heard and reviewed the accompanying notice of Harris Construction Company, LTD.  
 Job Location GRAND PARKWAY & HARLEM ROAD, RICHMOND, TX 77406  
 Date 5/23/2016 Bond No. SW 9708, Permit No. 2016-7314 to make use of certain Fort Bend County property subject to, "A Revised Order Regulating the Laying, Construction, Maintenance, and Repair of Buried Cables, Conduits, and Pole Lines, In, Under, Across or Along Roads, Streets, Highways, and Drainage Ditches in Fort Bend County, Texas, Under the Jurisdiction of the Commissioners Court of Fort Bend County, Texas," as passed by the Commissioners Court of Fort Bend County, Texas the 3rd day of August, 1987, recorded in Volume \_\_\_\_\_ of the Minutes of the Commissioners Court of Fort Bend County, Texas, to the extent that such order is not inconsistent with Article 1436a, Vernon's Texas Civil Statutes. Upon Motion of Commissioner \_\_\_\_\_ Meyers, seconded by Commissioner Patterson, duly put and carried, it is ORDERED, ADJUDGED AND DECREED that said notice of said above purpose is hereby acknowledged by the Commissioners Court of Fort Bend County, Texas, and that said notice be placed on record according to the regulation order thereof.

#### Notes:

1. Evidence of review by the Commissioners Court must be kept on the job site and failure to do so constitutes grounds for job shutdown.
2. Written notices are required:
  - a. 48 hours in advance of construction start up, and
  - b. when construction is completed and ready for final inspection
 Mail notices to: Permit Administrator  
 Fort Bend County Engineering  
 301 Jackson Street  
 Richmond, Texas 77469  
 281-633-7500
3. This permit expires one (1) year from date of permit if construction has not commenced.

By: \_\_\_\_\_

Charles O. [Signature]  
 County Engineer

N/A

By: \_\_\_\_\_

Drainage District Engineer/Manager

Presented to Commissioners Court and approved.

Recorded in Volume

617116 120  
 Minutes of Commissioners Court

Clerk of Commissioners Court


By: \_\_\_\_\_

Deputy

[Signature]  
 RENE E MICHULKA



APP-7885

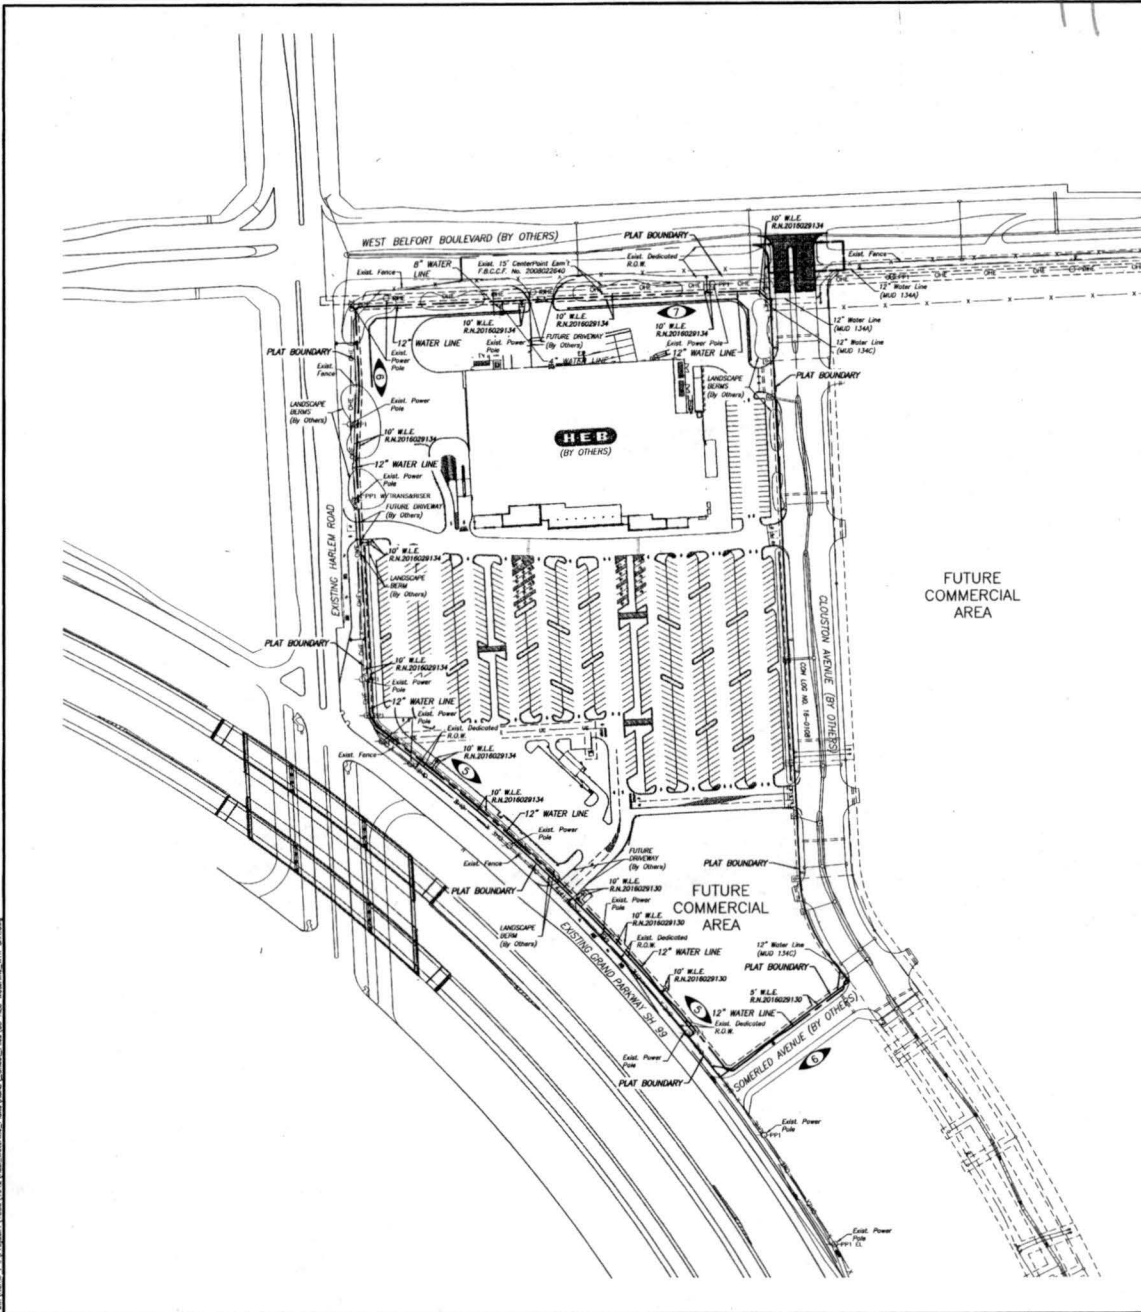

**LEGEND**

- PROPOSED WATER LINE AND GATE VALVE AND BOX
- PROPOSED WATER LINE W/BENDS
- PROPOSED WATER LINE W/TEE
- PROPOSED WATER LINE W/FIRE HYDRANT UNIT  
A. LINE SIZE X 6" TEE  
B. 6" GATE VALVE AND BOX  
C. FIRE HYDRANT
- 2" BLOW-OFF ASSEMBLY W/PLUG AND CLAMP
- EXISTING WATER LINE SYSTEM
- PROPOSED DOUBLE SANITARY SEWER LEAD
- PROPOSED SINGLE SANITARY SEWER LEAD
- PROPOSED SANITARY SEWER AND MANHOLE
- EXISTING SANITARY SEWER AND MANHOLE
- ⑩ INDICATES SHEET REFERENCE NUMBER
- ① INDICATES BLOCK NUMBER
- 1 INDICATES LOT NUMBER
- W.L.E. INDICATES WATERLINE EASEMENT
- S.M.S.E. INDICATES STORM SEWER EASEMENT
- S.S.E. INDICATES SANITARY SEWER EASEMENT

**BENCHMARK:**  
 A-1212 - BRASS BOLT STAMPED A-1212 1973 SET IN THE TOP OF A CONCRETE FOUNDATION ON THE WEST BOUNDARY LINES OF TONY BORN APPROX. 1/2 MILES WEST ALONG HWY 16A FROM THE JUNCTION OF HWY 5 IN EAST OF THE WEST END OF THE NORTH CONCRETE FOUNDATION AND 1/2 MILES NORTH OF THE CONCRETE CENTERLINE OF THE WESTBOUND LANES, AND ABOUT LOWER THAN THE ROAD.  
 ELEV. = 78.65 FEET (MVD-29) 1973 ADJ.  
 10M 8" TOP OF A CHISELED BOLT SET ON THE NORTHERN EDGE OF A MOUND OF FILL 144' IN FRONT OF LOCATED 1/4 MILE SOUTH OF THE CENTERLINE OF THE INTERSECTION OF HWY 16A AND HWY 160 WEST END 1/4 MILE WEST OF THE WEST END OF CONCRETE FOUNDATION FOR THE SUBGROUND LINE OF HWY 16A.  
 ELEV. = 88.55 FEET (MVD-29) 1973 ADJ.

**NOTES:**  
 I CERTIFY THAT THIS DRAWING REFLECTS THE IMPROVEMENTS CONSTRUCTED AS TO SIZE, LOCATION AND GRADE AND THAT THE CONSTRUCTION WAS IN FULL COMPLIANCE WITH THE CONTRACT DOCUMENTS  
 DATE: 4/22/16

**RECORD DRAWING**

FORT BEND COUNTY ENGINEERING DEPARTMENT  
 APPROVED: *Maggie Gooden*  
 LICENSED PROFESSIONAL ENGINEER  
 DATE: 4/22/16

C.O.H. LOG NO. 16-0236  
 ALIANA DEVELOPMENT COMPANY

ALIANA COMMERCIAL CENTER  
 WATER LAYOUT

**LJA Engineering, Inc.**  
 2629 Briarpark Drive Phone 713.953.5500  
 Suite 600 Houston, Texas 77062 Fax 713.953.5626  
 F704-F-1386  
 LJA PROJECT NO.: 1883-1042  
 DESIGNED BY: KFS DRAWN BY: KFS DATE: MARCH 2016

**CITY OF HOUSTON**  
 DEPARTMENT OF PUBLIC WORKS AND ENGINEERING  
 STREET & UTILITY  
 DATE: 4/22/16  
 DRAWN: KFS  
 CHECKED: KFS  
 SCALE: 1" = 100'  
 SHEET NO. 3 OF 9



12 INCH WATER DISTRIBUTION LOOP LINE TO SERVE ALIANA COMMERCIAL CENTER - JOB NO. 1883-1042